

WARNING TO CONTRACTOR:
CALL TEXAS 811 (LOCATING SERVICE) OR OTHER UTILITY LOCATING SERVICES 48 HOURS PRIOR TO CONSTRUCTION ACTIVITY. EXISTING UTILITY DATA IS PROVIDED FOR INFORMATION ONLY. ALTHOUGH THIS DATA IS SHOWN AS ACCURATELY AS POSSIBLE, THE CONTRACTOR IS CAUTIONED THAT DUNAWAY ASSOCIATES L.P. DOES NOT ASSUME OR IMPLY ANY RESPONSIBILITY FOR THE ACCURACY OF THIS DATA.

UTILITY NOTE:
THE UTILITIES SHOWN ON THE PLANS WERE COMPILED FROM VARIOUS SOURCES AND ARE INTENDED TO SHOW THE GENERAL EXISTENCE AND LOCATION OF UTILITIES IN THE AREA OF CONSTRUCTION. THE ENGINEER ASSUMES NO RESPONSIBILITY FOR THE ACCURACY OF THE UTILITY INFORMATION SHOWN ON THE PLANS. THE CONTRACTOR SHALL VERIFY THE EXACT LOCATION OF ALL UTILITIES PRIOR TO CONSTRUCTION. THE CONTRACTOR SHALL CONTACT UTILITY COMPANIES 48 HOURS IN ADVANCE OF ANY CONSTRUCTION ACTIVITIES IN ORDER TO DETERMINE IF THERE IS ANY CONFLICT WITH THE PROPOSED FACILITY. THE CONTRACTOR SHALL NOTIFY THE ENGINEER IMMEDIATELY WHEN CONFLICTS WITH EXISTING UTILITIES ARE DISCOVERED. THE FOLLOWING PHONE NUMBERS ARE PROVIDED FOR CONVENIENCE. CONSIDERATION OF OTHER UTILITIES MAY BE REQUIRED.

FORT WORTH WATER DEPT (817) 392-8296
FORT WORTH TPW (817) 392-8100
TEXAS 811 (LOCATING SERVICE) (888) 438-2427
CHARTER COMMUNICATIONS (TV CABLE) (800) 624-9675
MCI (OWNER OF WESTERN UNION LINES) (817) 338-6202
AT&T (800) 483-1000
VERIZON (800) 817-8090
ATMOS ENERGY (888) 215-6688
ONCOR ELECTRIC DELIVERY (800) 521-0579
SPRINT (800) 521-0579
ZAYO

NO.	DATE	REVISIONS	DESCRIPTION
1	11/07/2025	# # # # #	ADDENDUM #1

DUNAWAY
550 Bailey Avenue • Suite 400 • Fort Worth, Texas 76107
Tel: 817-235-1121
Tx Reg. F-1114

FIBER LOOP - OVERALL LAYOUT

JPS CAMPUS FIBER LOOP PROJECT
FORT WORTH, TX



12/23/2025
HUNTER M. BRAUER
138744
LICENSING
HUNTER BRAUER

JOB NO. 12229.001
DESIGNED BY: HB
DRAWN BY: AC/EG
CHECKED BY: HB
DATE: DEC 2025
SHEET: C2.0

100 0 100 200
GRAPHIC SCALE IN FEET

GENERAL NOTES


1. CONFIRM EXISTING CONDITIONS IN THE FIELD PRIOR TO PERFORMING ANY WORK.
2. EXISTING BUILDINGS ARE TO REMAIN OPERATIONAL THROUGHOUT CONSTRUCTION. COORDINATE ANY UNFORESEEN OUTAGES WITH THE JPS I.T. MANAGER PRIOR TO PERFORMING THE WORK.
3. COORDINATE COMMUNICATION PATHWAY SYSTEMS WITH OTHER UTILITIES PRIOR TO INSTALLATION.
4. COORDINATE ENTRY INTO THE BUILDING WITH JPS PDC AND STRUCTURAL ENGINEERS PRIOR TO INSTALLATION.
5. REFER TO TECHNOLOGY PLANS FOR HAND HOLE / VAULT DETAILS FOR SPECIFICATIONS ON CONDUIT PENETRATIONS, INCLUDING REQUIRED QUANTITIES AND ADDITIONAL INSTALLATION REQUIREMENTS.
6. CONDUIT FROM HAND HOLES/VAULTS TO BUILDINGS TO BE INSTALLED BY OTHERS AND SHOWN FOR REFERENCE ONLY.
7. CONDUITS CROSSING PUBLIC RIGHT-OF-WAY TO BE PLACED IN SINGLE BORE PIPES UNLESS NOTED OTHERWISE. REFER TO CIVIL ENCROACHMENT AGREEMENT EXHIBITS FOR CROSSINGS AND DEPTH.

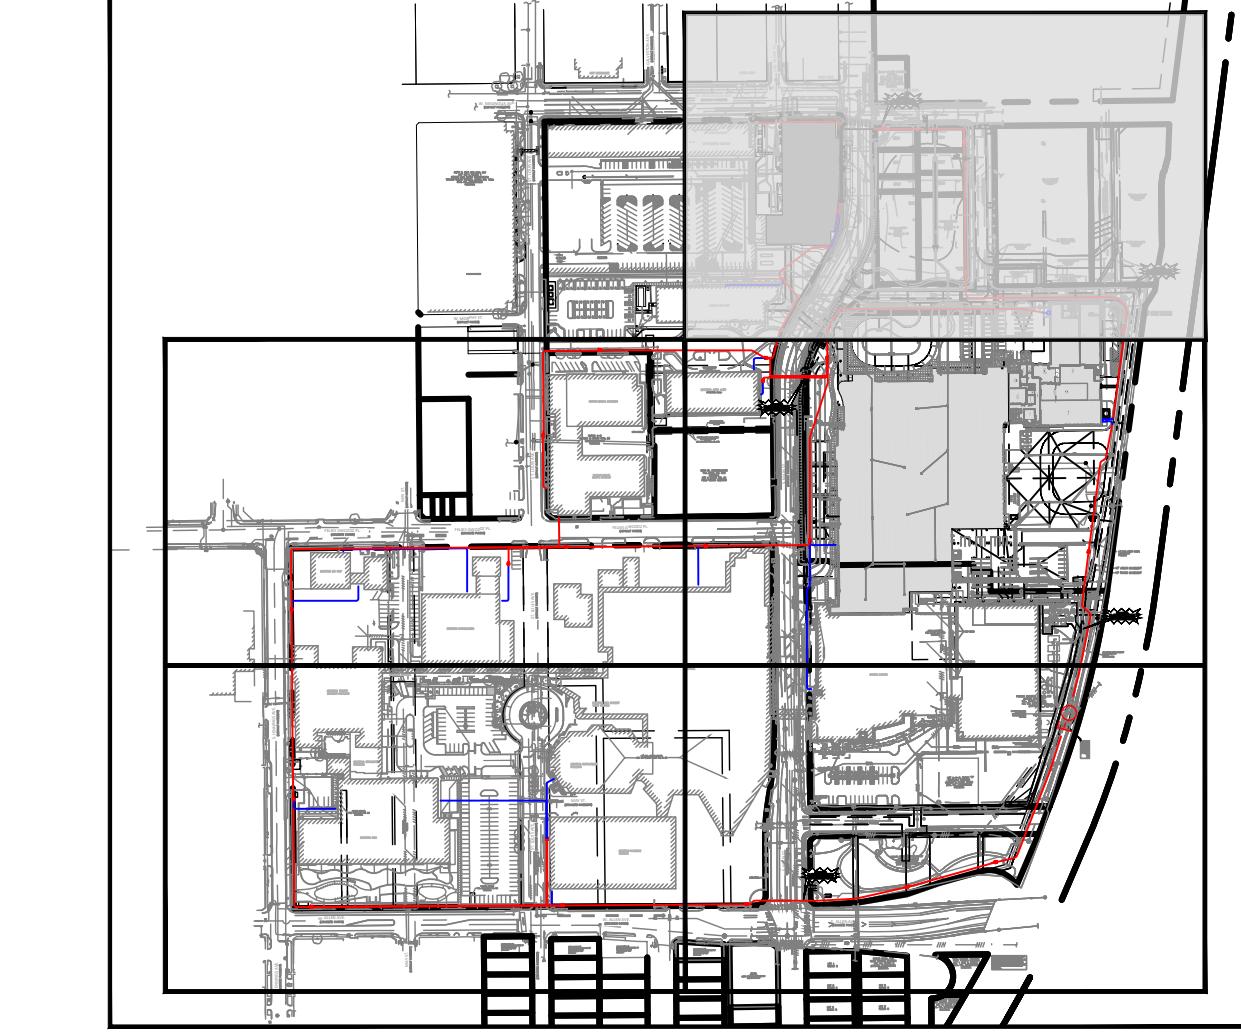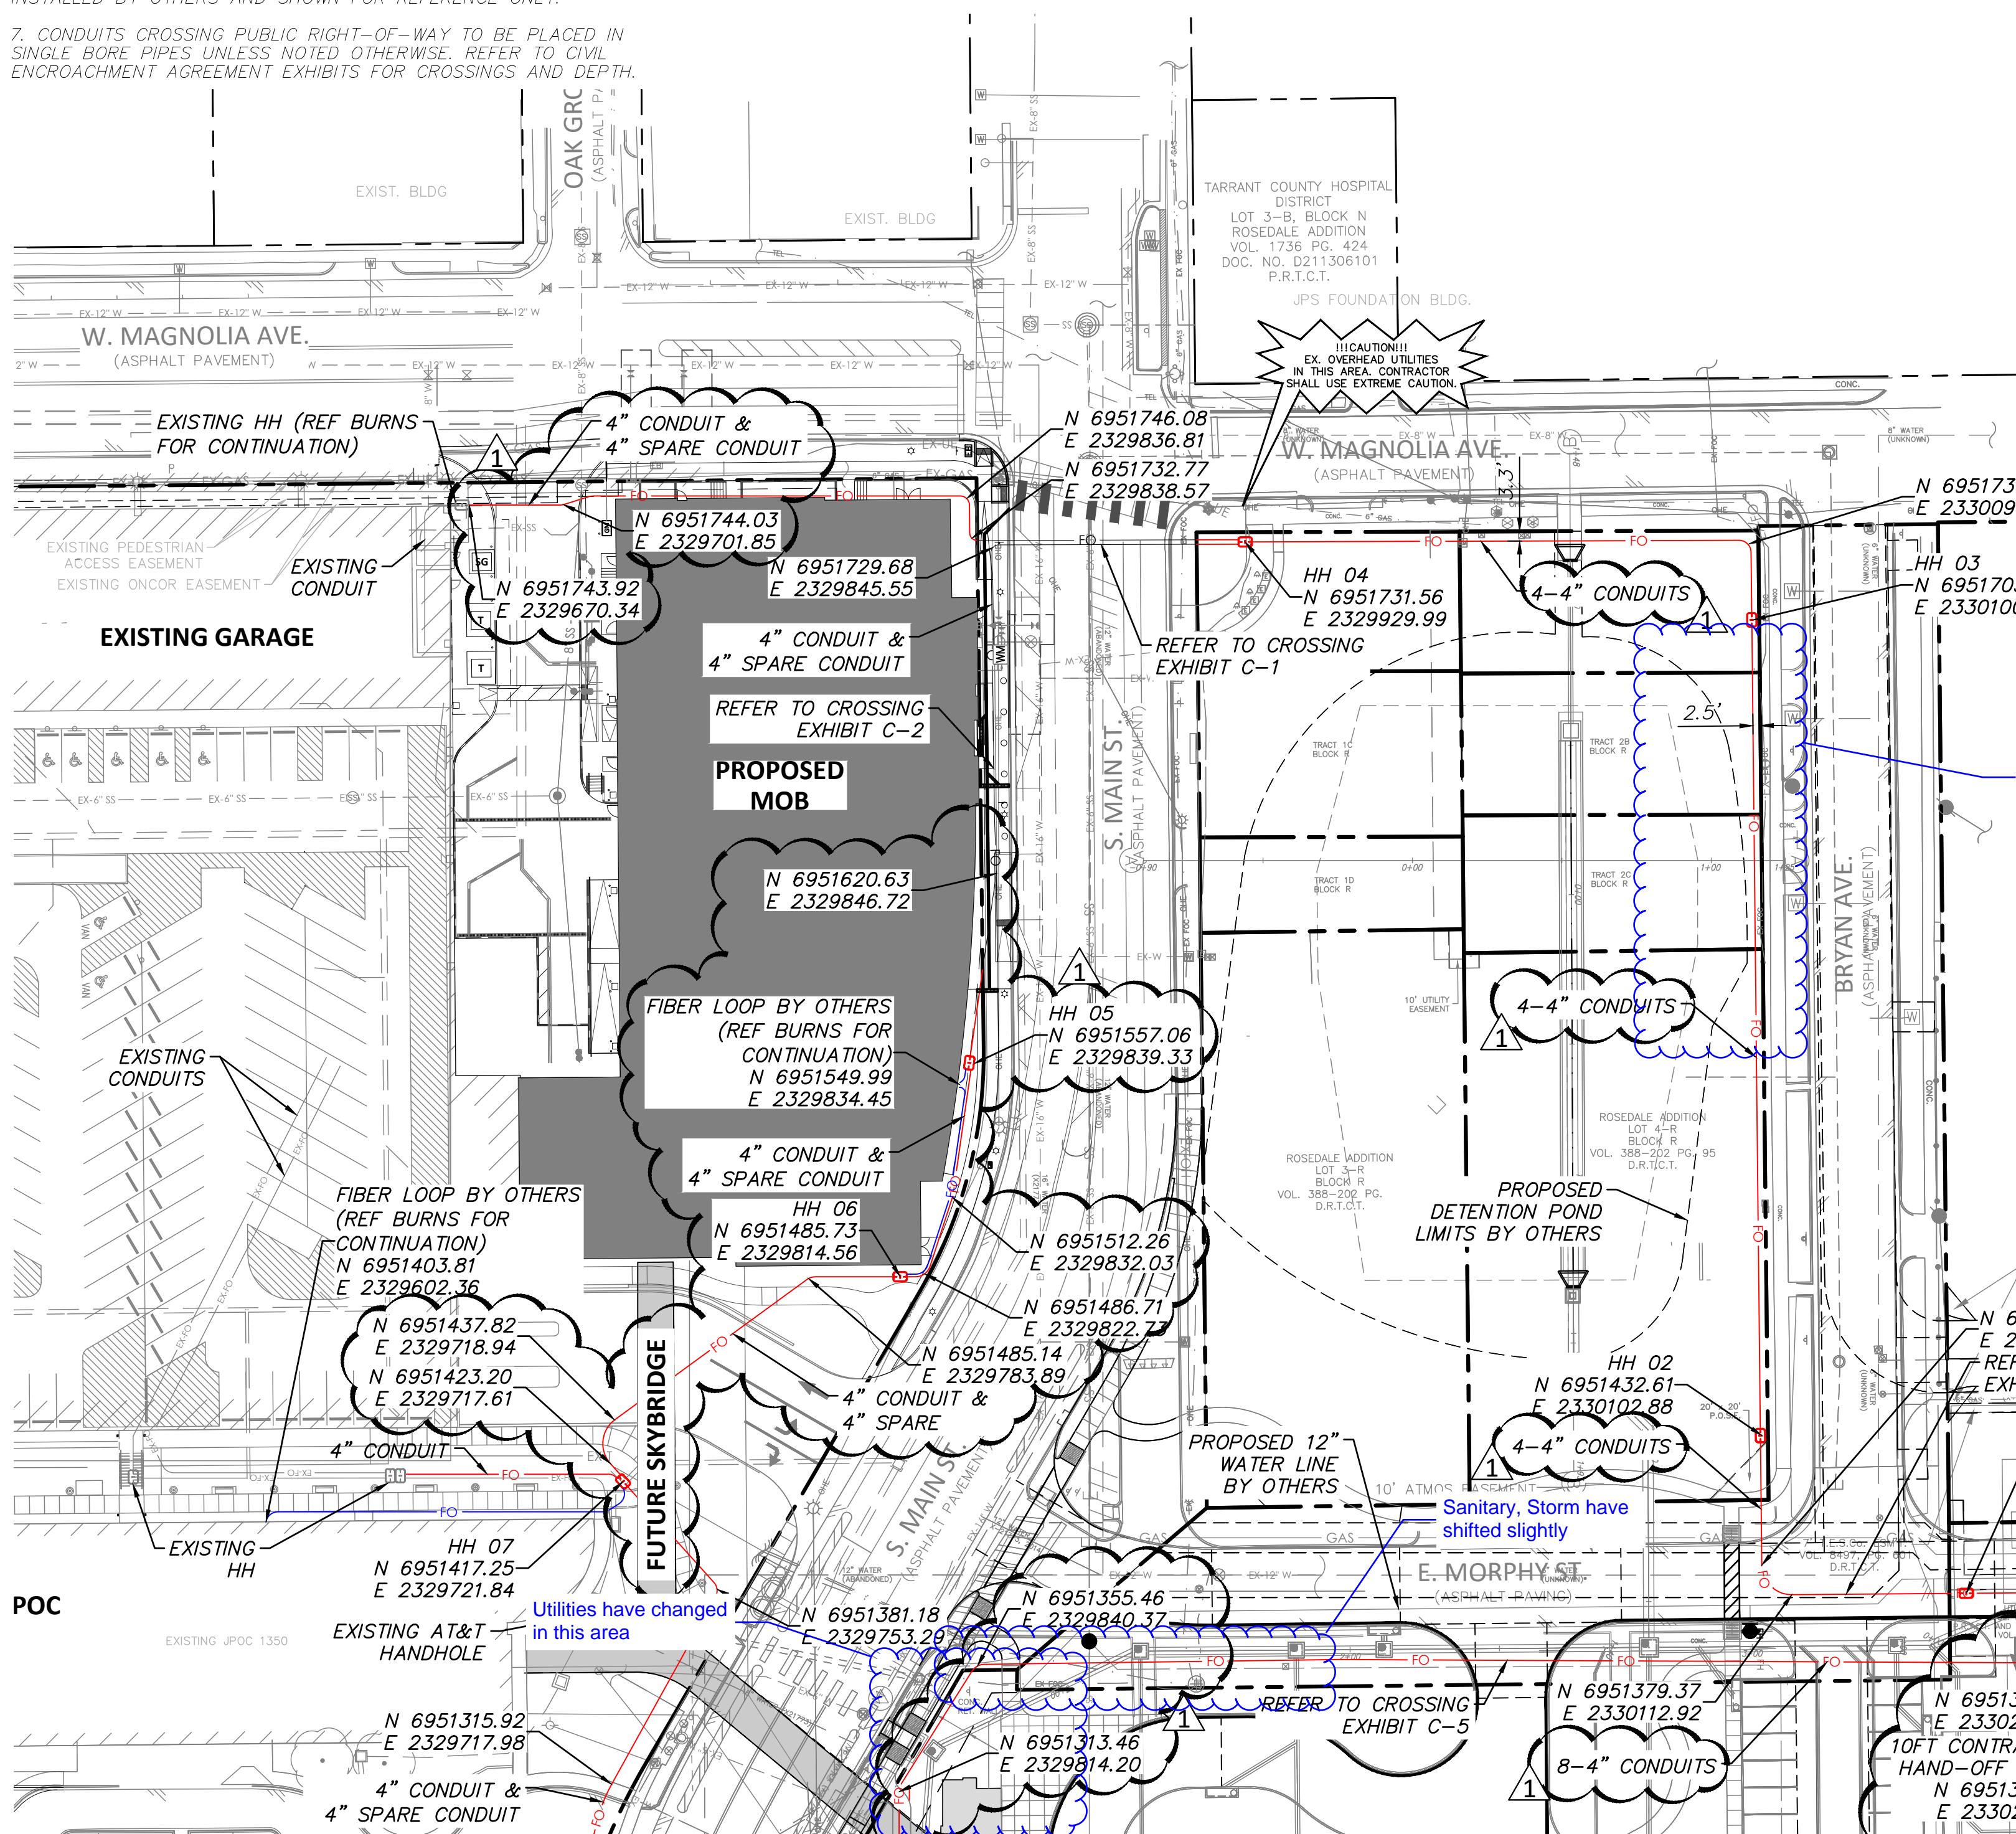

WARNING TO CONTRACTOR:	
CALL TEXAS 811 (LOCATING SERVICE) OR OTHER UTILITY LOCATING SERVICES 48 HOURS PRIOR TO CONSTRUCTION ACTIVITY. EXISTING UTILITY DATA IS PROVIDED FOR INFORMATION ONLY. ALTHOUGH THIS DATA IS SHOWN AS ACCURATELY AS POSSIBLE, THE CONTRACTOR IS CAUTIONED THAT DUNAWAY ASSOCIATES L.P. DOES NOT ASSUME OR IMPLY ANY RESPONSIBILITY FOR THE ACCURACY OF THIS DATA.	
UTILITY NOTE: THE UTILITIES SHOWN ON THE PLANS WERE COMPILED FROM VARIOUS SOURCES AND ARE INTENDED TO SHOW THE GENERAL EXISTENCE AND LOCATION OF UTILITIES IN THE AREA OF CONSTRUCTION. THE ENGINEER ASSUMES NO RESPONSIBILITY FOR THE ACCURACY OF THE UTILITY INFORMATION SHOWN ON THE PLANS. THE CONTRACTOR SHALL VERIFY THE EXACT LOCATION OF ALL UTILITIES PRIOR TO CONSTRUCTION. THE CONTRACTOR SHALL CONTACT UTILITY COMPANIES 48 HOURS IN ADVANCE OF ANY CONSTRUCTION ACTIVITIES TO DETERMINE IF THERE IS ANY CONFLICT WITH THE PROPOSED FACILITY. THE CONTRACTOR SHALL NOTIFY THE ENGINEER IMMEDIATELY WHEN CONFLICTS WITH EXISTING UTILITIES ARE DISCOVERED. THE FOLLOWING PHONE NUMBERS ARE PROVIDED FOR CONVENIENCE. CONSIDERATION OF OTHER UTILITIES MAY BE REQUIRED.	

FORT WORTH WATER DEPT (817) 392-8296
TEXAS 811 (LOCATING SERVICE) (817) 392-8100
CHARTER COMMUNICATIONS (TV CABLE) (888) 438-2427
MCI (OWNER OF WESTERN UNION LINES) (800) 624-9675
AT&T (817) 338-6202
VERIZON (800) 483-1000
ATMOS ENERGY (800) 817-8090
ONCR ELECTRIC DELIVERY (888) 215-6688
SPRINT (800) 521-0579
ZAYO


NO.	DATE	REVISIONS	DESCRIPTION
1	11/07/2025	# # # # #	APPENDIX #1

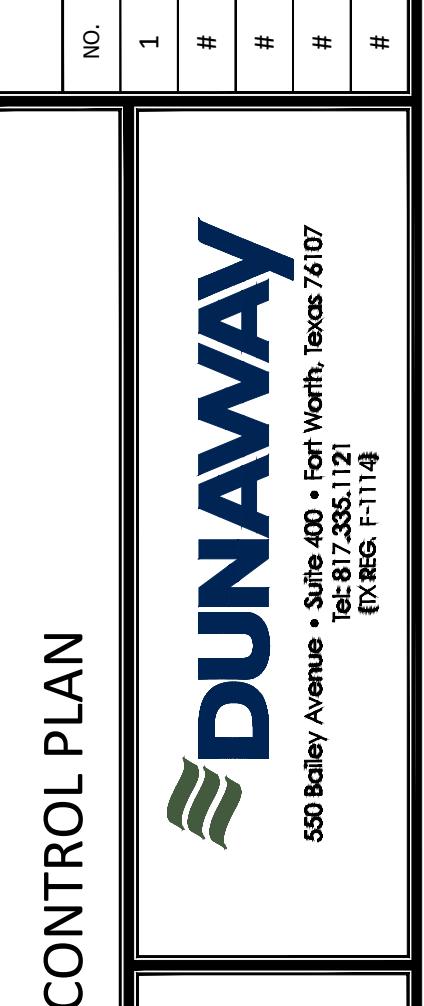

DUNAWAY
550 Bailey Avenue • Suite 400 • Fort Worth, Texas 76107
Tel: 817-235-1121
Tx Reg. F-1114


12/23/2025
STATE OF TEXAS
HUNTER M. BRAUER
138744
LICENSED
<i>Hunter M. Brauer</i>
JOB NO. 12229.001
DESIGNED BY: HB
DRAWN BY: AC/EG
CHECKED BY: HB
DATE: DEC 2025
SHEET: C2.1

C2.1

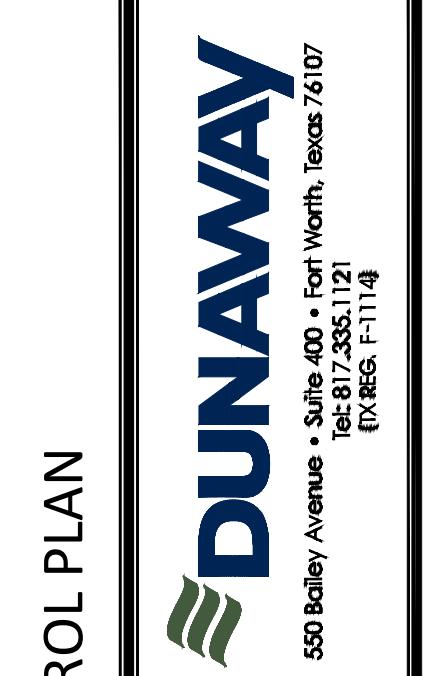

JPS CAMPUS
FIBER LOOP PROJECT
FORT WORTH, TX

MATCH LINE SHEET C2.5

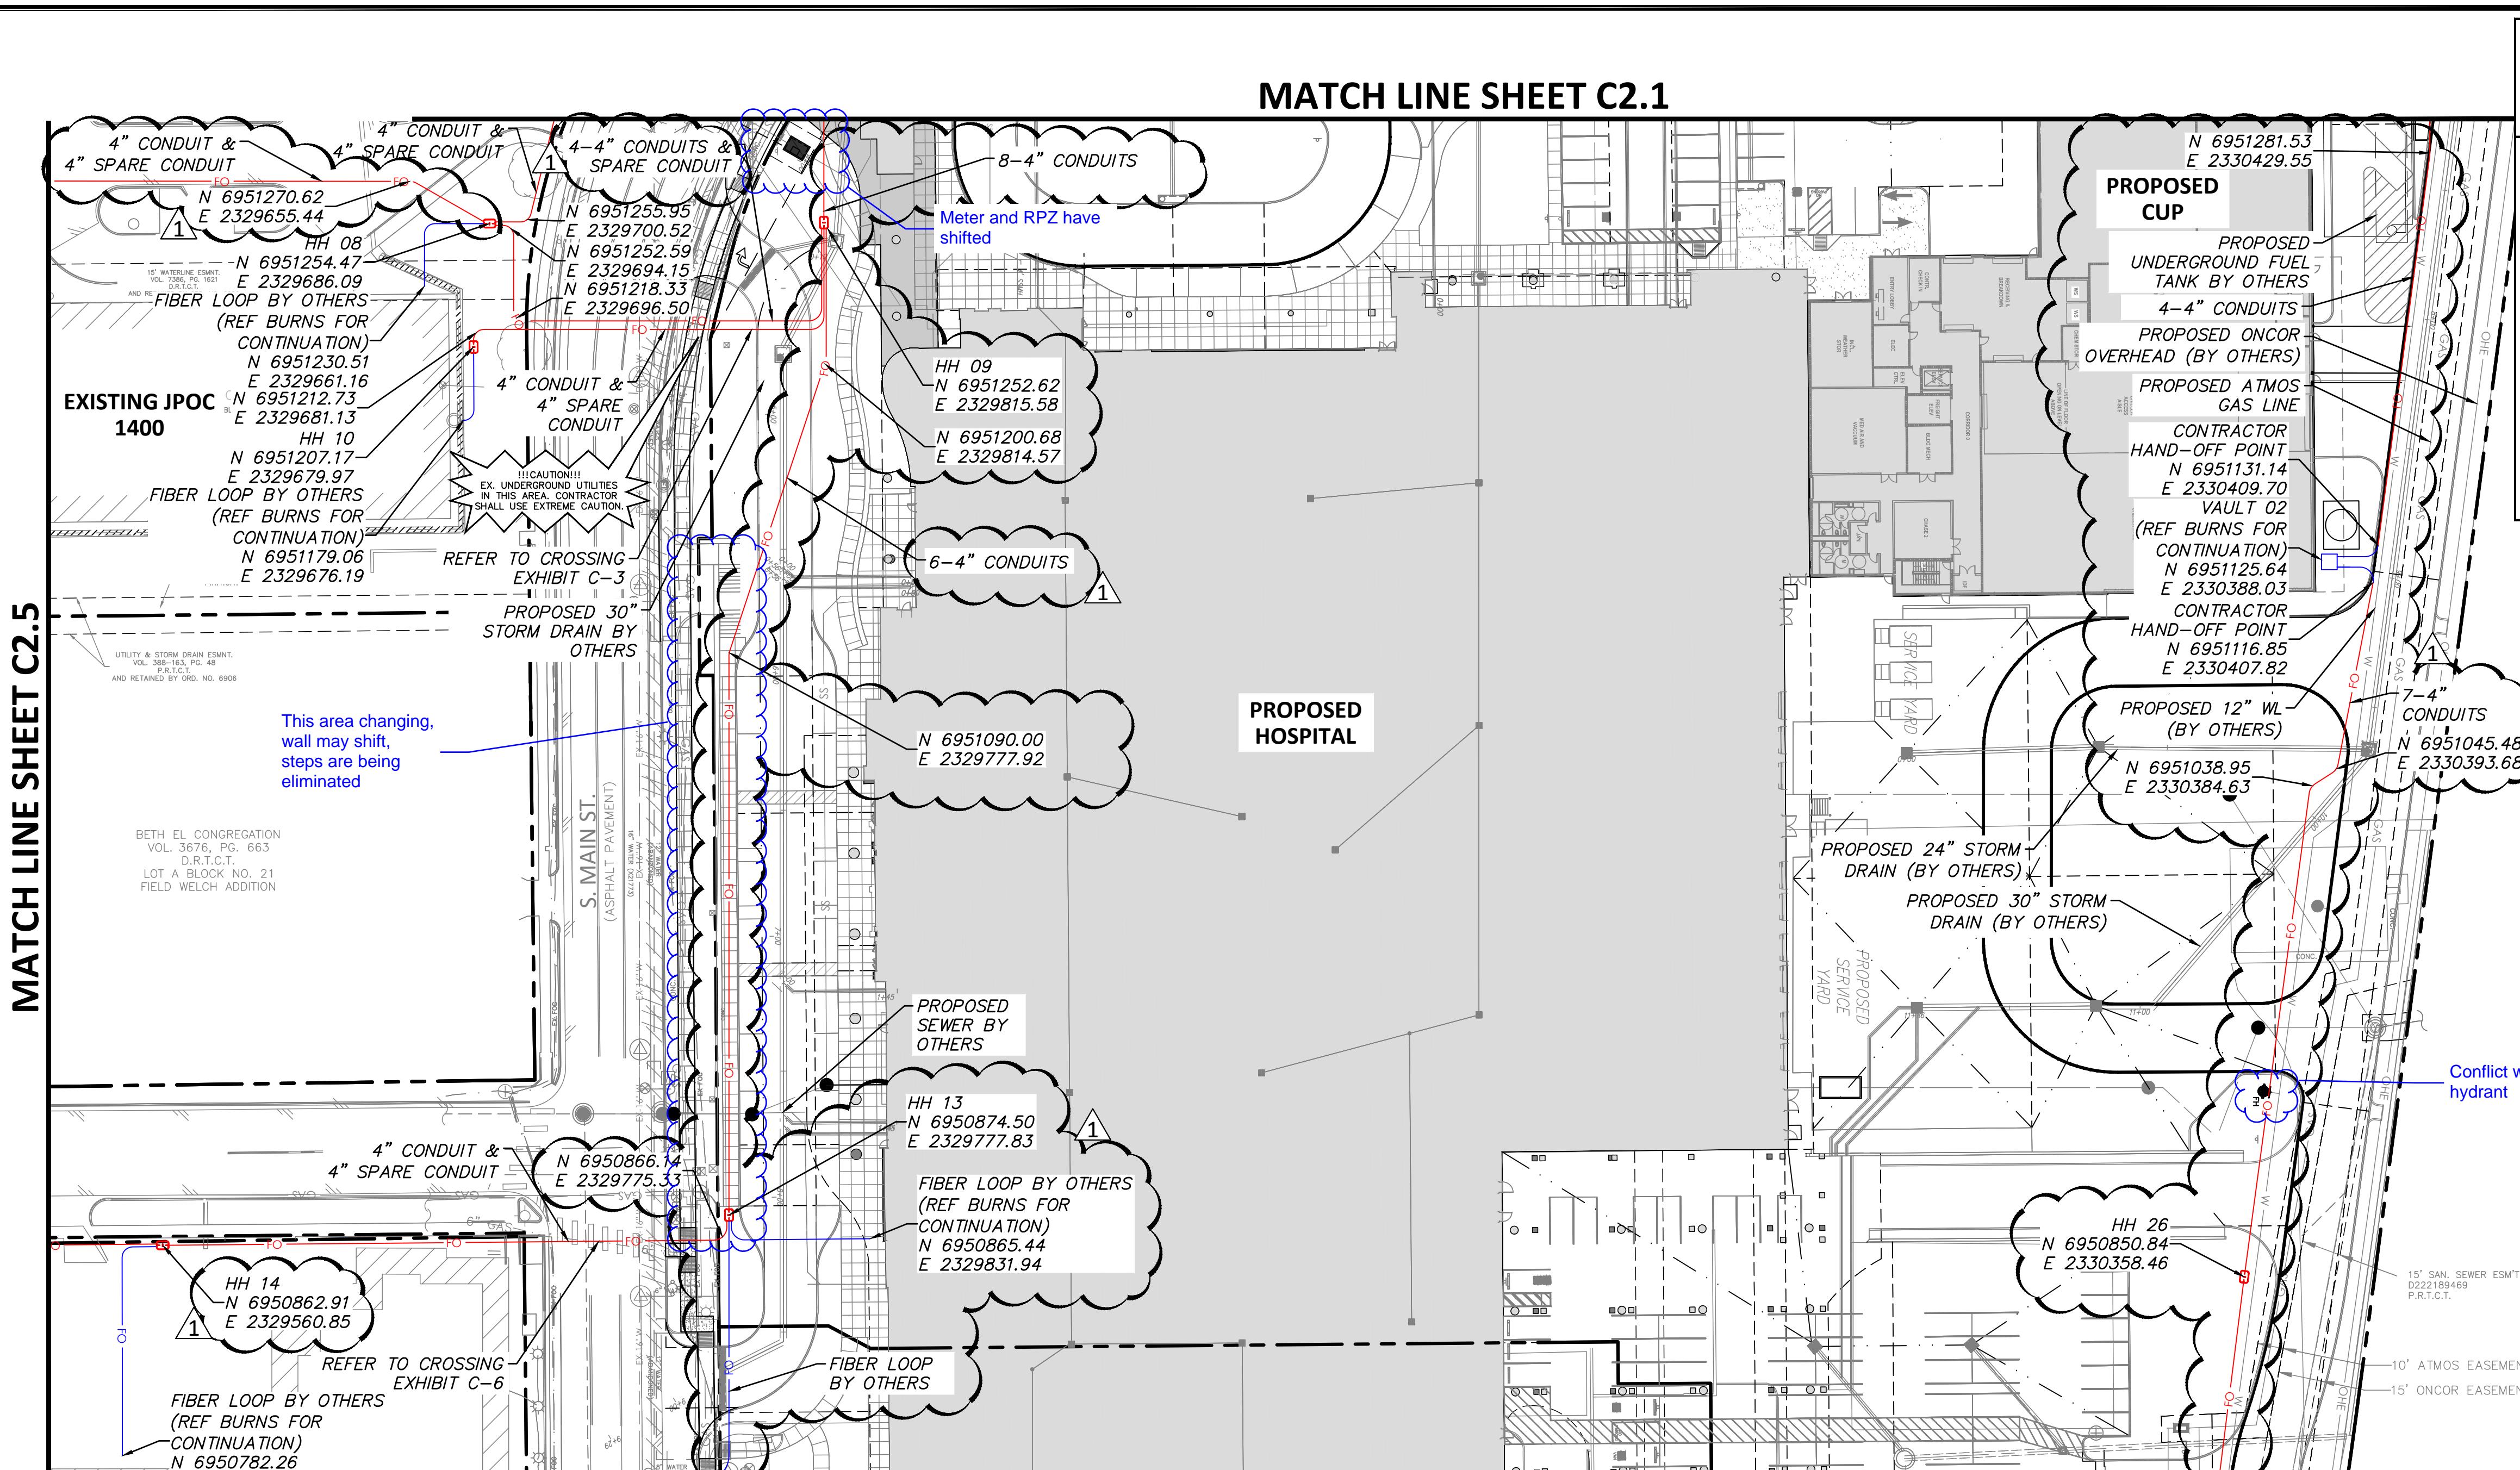

MATCH LINE SHEET C2.1

WARNING TO CONTRACTOR:
CALL TEXAS 811 (LOCATING SERVICE) OR OTHER UTILITY LOCATING SERVICES 48 HOURS PRIOR TO CONSTRUCTION ACTIVITY. EXISTING UTILITY DATA IS PROVIDED FOR INFORMATION ONLY. ALTHOUGH THIS DATA IS SHOWN AS ACCURATELY AS POSSIBLE, THE CONTRACTOR IS CAUTIONED THAT DUNAWAY ASSOCIATES L.P. DOES NOT ASSUME OR IMPLY ANY RESPONSIBILITY FOR THE ACCURACY OF THIS DATA.

UTILITY NOTE:
THE UTILITIES SHOWN ON THE PLANS WERE COMPILED FROM VARIOUS SOURCES AND ARE INTENDED TO SHOW THE GENERAL EXISTENCE AND LOCATION OF UTILITIES IN THE AREA OF CONSTRUCTION. THE ENGINEER ASSUMES NO RESPONSIBILITY FOR THE ACCURACY OF THE UTILITY INFORMATION SHOWN ON THE PLANS. THE CONTRACTOR SHALL VERIFY THE EXACT LOCATION OF ALL UTILITIES PRIOR TO CONSTRUCTION. THE CONTRACTOR SHALL CONTACT UTILITY COMPANIES 48 HOURS IN ADVANCE OF ANY CONSTRUCTION ACTIVITIES IN ORDER TO DETERMINE IF THERE ARE ANY CONFLICTS WITH THE PROPOSED FACILITY. THE CONTRACTOR SHALL NOTIFY THE ENGINEER IMMEDIATELY WHEN CONFLICTS WITH EXISTING UTILITIES ARE DISCOVERED. THE FOLLOWING PHONE NUMBERS ARE PROVIDED FOR CONVENIENCE. CONSIDERATION OF OTHER UTILITIES MAY BE REQUIRED.

FORT WORTH WATER DEPT (817) 392-8296
FORT WORTH 811 (LOCATING SERVICE) (817) 392-8100
CHARTER COMMUNICATIONS (TV CABLE) (888) 438-2427
MCI (OWNER OF WESTERN UNION LINES) (800) 624-9675
AT&T (817) 338-6202
VERIZON (800) 483-1000
ATMOS ENERGY (800) 817-8090
ONCOR ELECTRIC DELIVERY (888) 215-6688
SPRINT (800) 521-0579
ZAYO

NO.	DATE	REVISIONS	DESCRIPTION
1	11/07/2025	# # # # #	APPENDIX #1

DUNAWAY
550 Bailey Avenue • Suite 400 • Fort Worth, Texas 76107
Tel: 817-235-1121
Tx Reg. F-114



DIMENSIONAL CONTROL PLAN

JPS CAMPUS FIBER LOOP PROJECT FORT WORTH, TX

12/23/2025
STATE OF TEXAS
HUNTER M. BRAUER
138744
LICENSED
HUNTER M. BRAUER

JOB NO. 12229.001
DESIGNED BY: HB
DRAWN BY: AC/EG
CHECKED BY: HB
DATE: DEC 2025
SHEET: C2.2

MATCH LINE SHEET C2.3

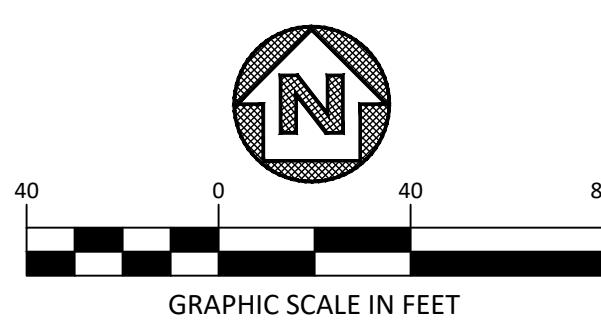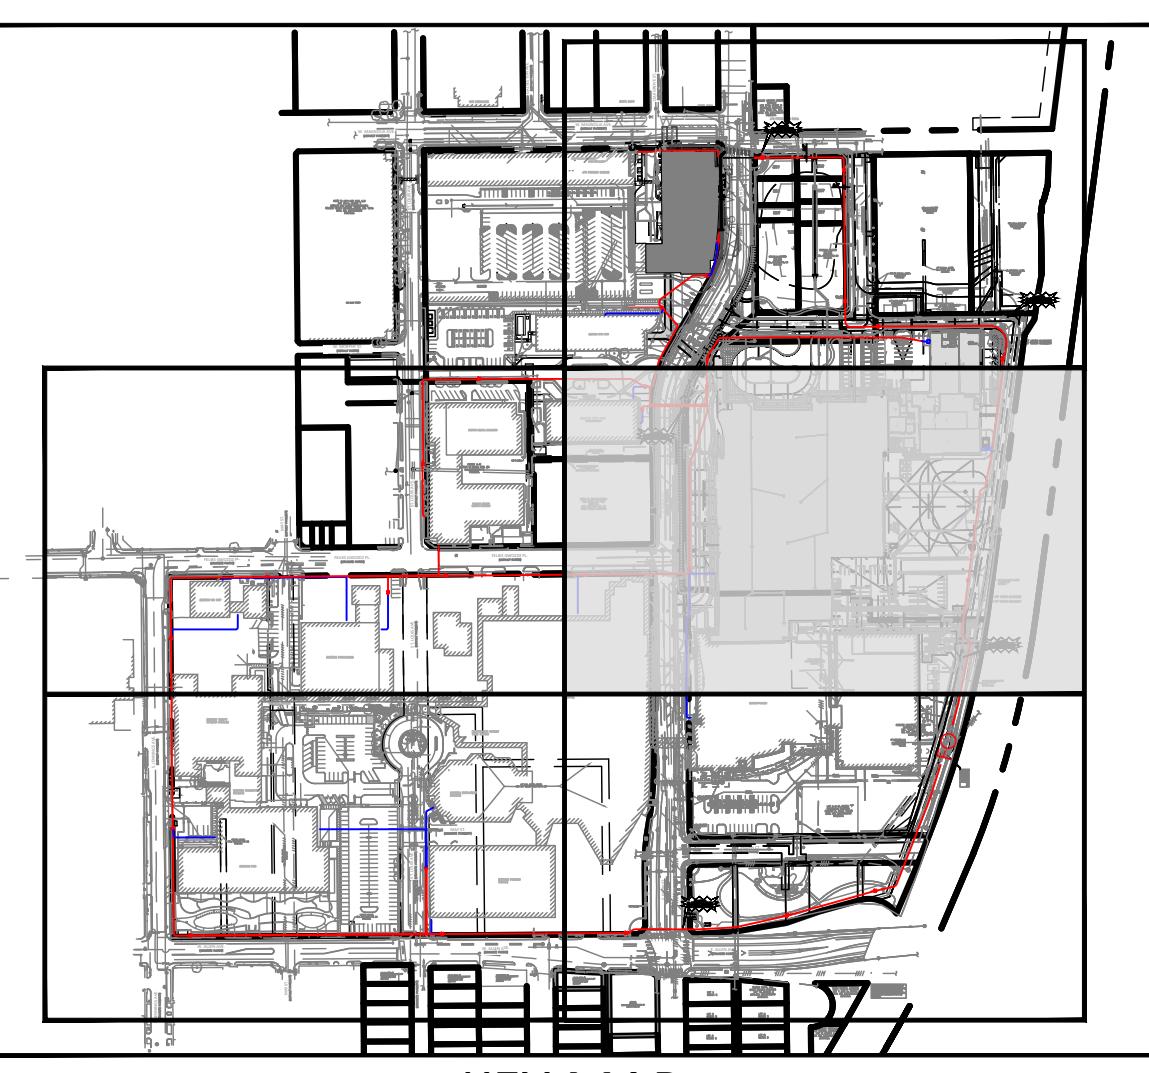


KEY MAP

C2.2

MATCH LINE SHEET C2.2

MATCH LINE SHEET C2.4

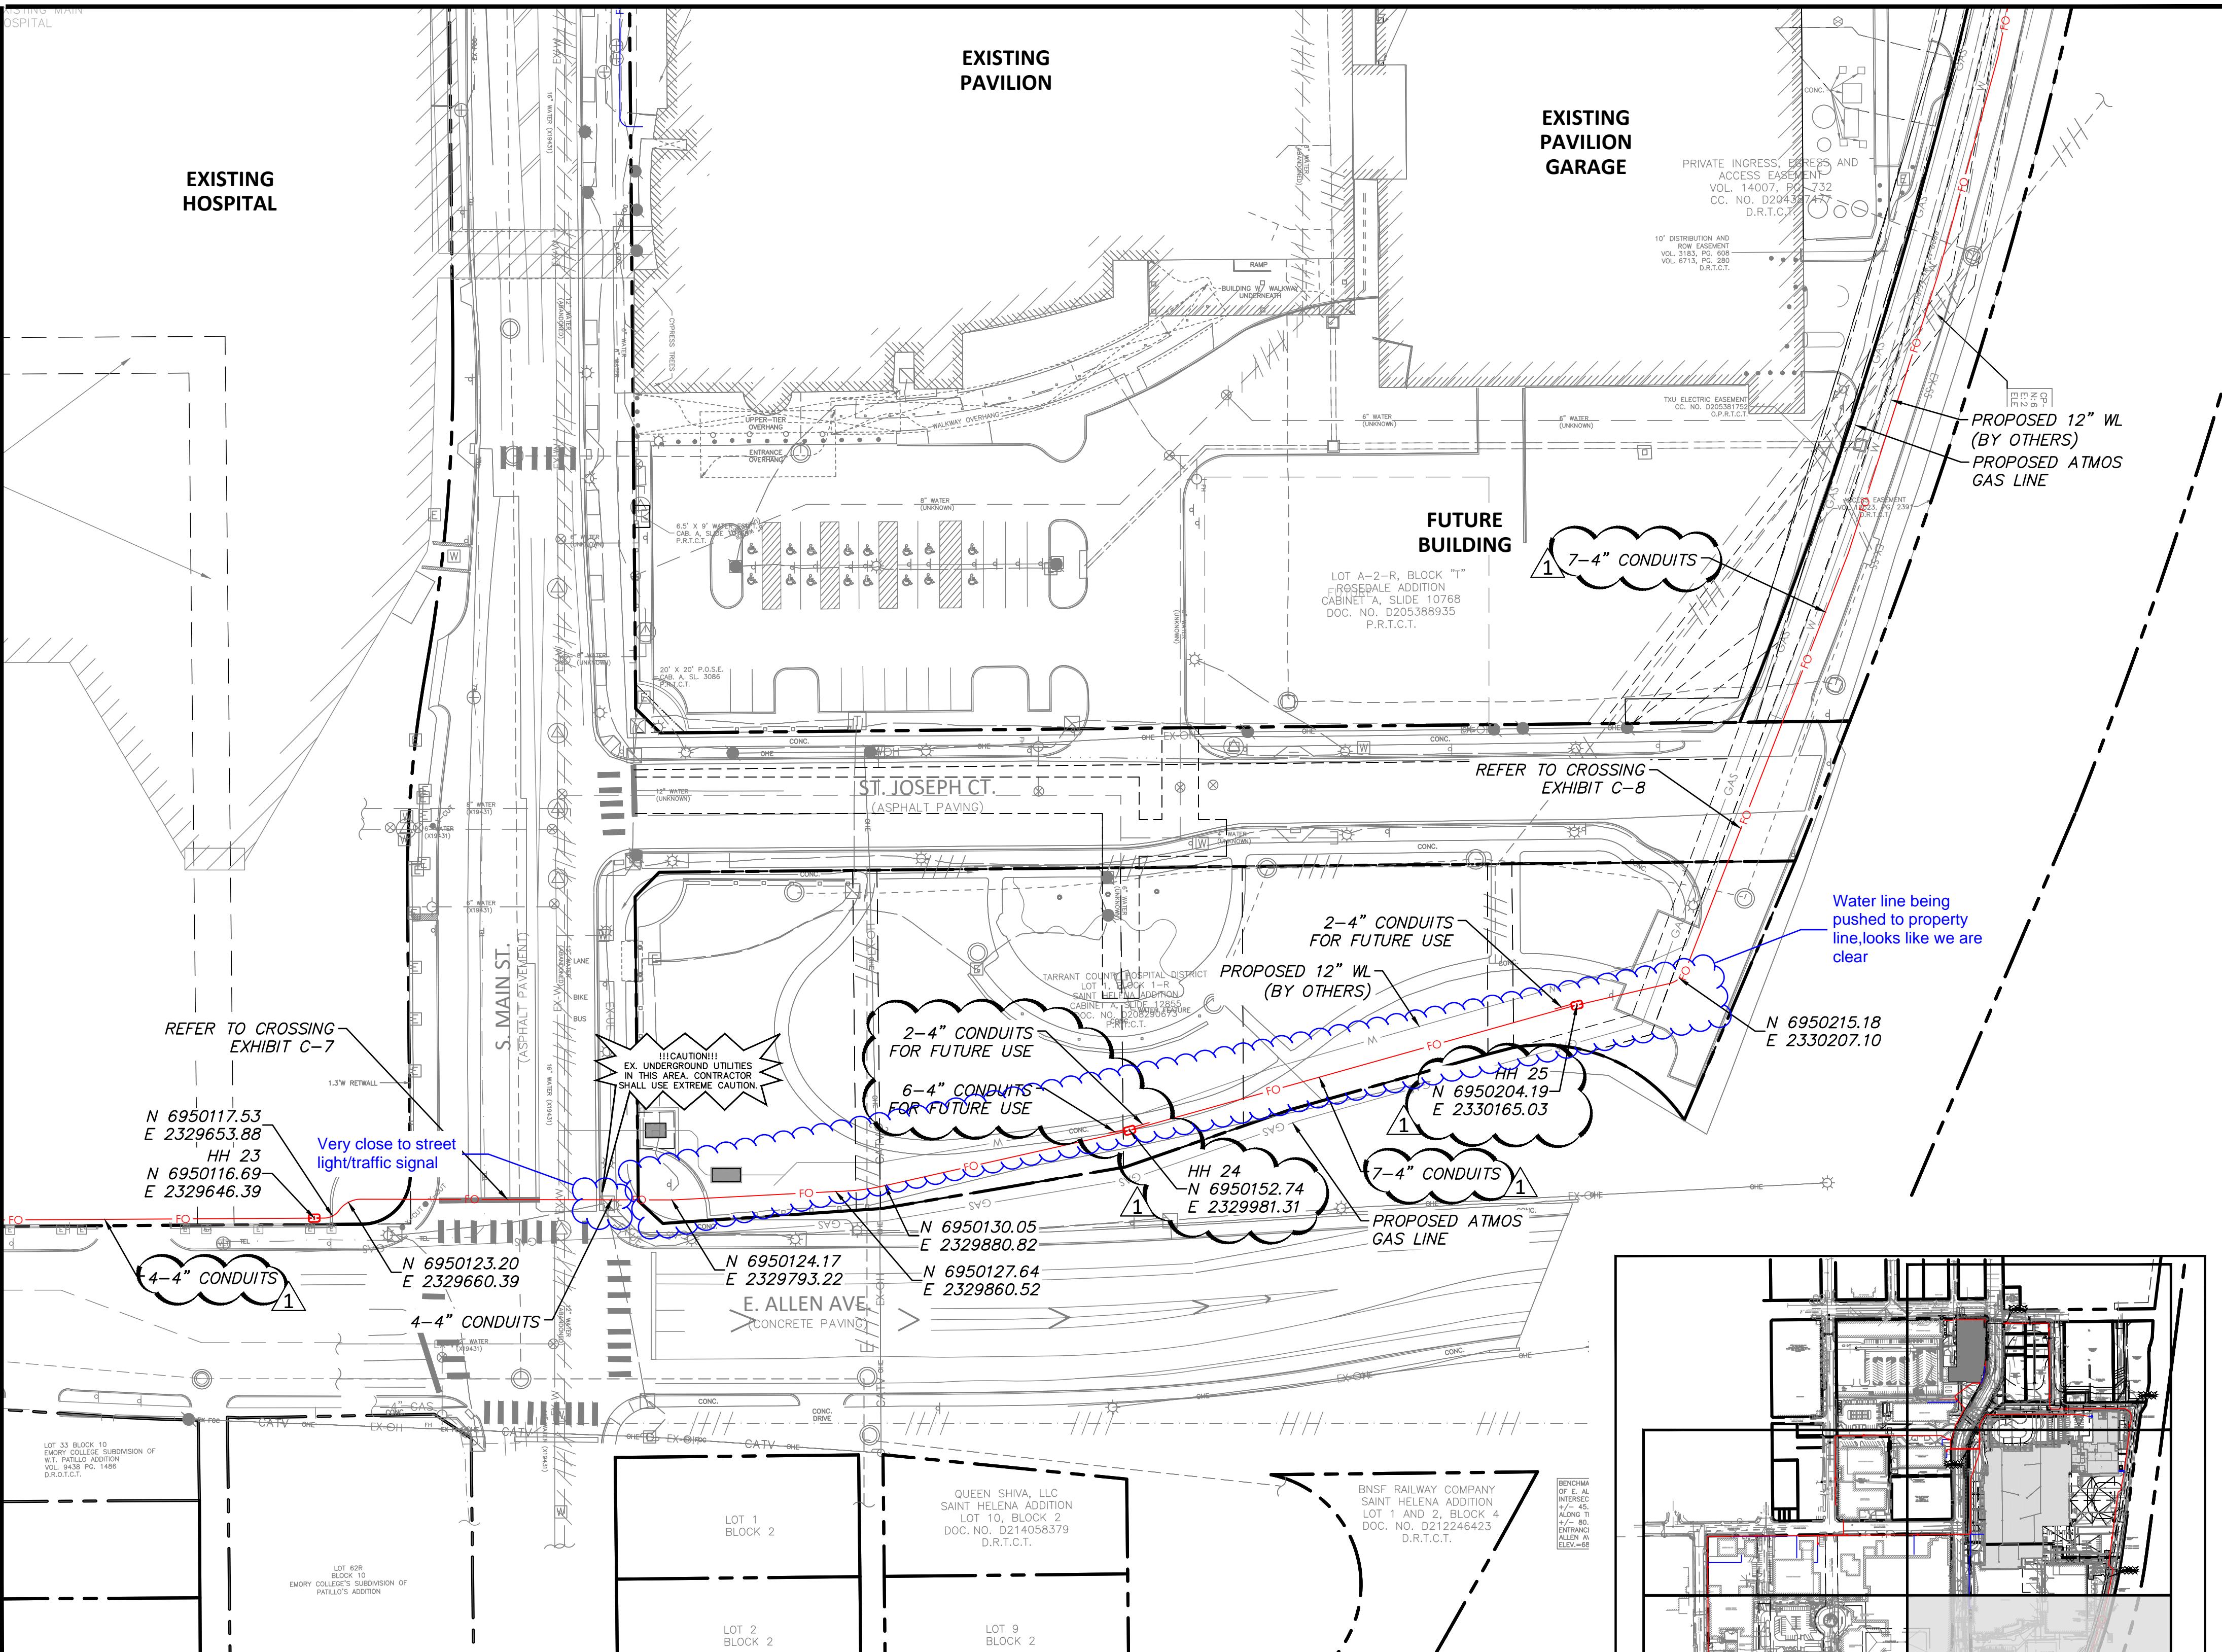

KEY MAP

WARNING TO CONTRACTOR:

CALL TEXAS 811 (LOCATING SERVICE) OR OTHER UTILITY LOCATING SERVICES 48 HOURS PRIOR TO CONSTRUCTION ACTIVITY. EXISTING UTILITY DATA IS PROVIDED FOR INFORMATION ONLY. ALTHOUGH THIS DATA IS SHOWN AS ACCURATELY AS POSSIBLE, THE CONTRACTOR IS CAUTIONED THAT DUNAWAY ASSCIATES L.P. DOES NOT ASSUME OR IMPLY ANY RESPONSIBILITY FOR THE ACCURACY OF THIS DATA.

UTILITY NOTE:

THE UTILITIES SHOWN ON THE PLANS WERE COMPILED FROM VARIOUS SOURCES AND ARE INTENDED TO SHOW THE GENERAL EXISTENCE AND LOCATION OF UTILITIES IN THE AREA OF CONSTRUCTION. THE ENGINEER ASSUMES NO RESPONSIBILITY FOR THE ACCURACY OF THE UTILITY INFORMATION SHOWN ON THE PLANS. THE CONTRACTOR SHALL VERIFY THE EXACT LOCATION OF ALL UTILITIES PRIOR TO CONSTRUCTION. THE CONTRACTOR SHALL CONTACT UTILITY COMPANIES 48 HOURS IN ADVANCE OF ANY CONSTRUCTION ACTIVITIES IN ORDER TO DETERMINE IF THERE IS ANY CONFLICT WITH THE PROPOSED FACILITIES. THE CONTRACTOR SHALL NOTIFY THE ENGINEER IMMEDIATELY WHEN CONFLICTS WITH EXISTING UTILITIES ARE DISCOVERED. THE FOLLOWING PHONE NUMBERS ARE PROVIDED FOR CONVENIENCE. CONSIDERATION OF OTHER UTILITIES MAY BE REQUIRED.

FORT WORTH WATER DEPT	(817) 392-8296
FORT WORTH TPW	(817) 392-8100
TEXAS 811 (LOCATING SERVICE)	811
CHARTER COMMUNICATIONS (TV CABLE)	(888) 438-2427
MCI (OWNER OF WESTERN UNION LINES)	(800) 624-9675
AT&T	(817) 338-6202
VERIZON	(800) 483-1000
ATMOS ENERGY	(800) 817-8090
ONCOR ELECTRIC DELIVERY	(888) 215-6688
SPRINT	(800) 521-0579
ZAYO	


UTILITY LEGEND	
	PROPERTY BOUNDARY
	ADJOINERS
	FIBER OPTIC LINE
	FIBER OPTIC LINE (BY OTHERS)
	STORM DRAIN (BY OTHERS)
	WATER LINE (BY OTHERS)
	SANITARY SEWER LINE (BY OTHERS)
	GAS LINE (BY OTHERS)
	OVERHEAD ELECTRIC (BY OTHERS)
	UNDERGROUND ELECTRIC (BY OTHERS)
	SANITARY SEWER MANHOLE (BY OTHERS)
	SANITARY SEWER CLEANOUT (BY OTHERS)
	WATER METER (BY OTHERS)
	FIRE HYDRANT (BY OTHERS)
	GATE VALVE (BY OTHERS)
	EXISTING SANITARY SEWER LINE
	EXISTING WATER LINE
	EXISTING GAS LINE
	EXISTING UNDERGROUND ELECTRIC
	EXISTING FIBER OPTIC
	EXISTING OVERHEAD ELECTRIC
	EXISTING TELEPHONE
	EXISTING STORM DRAIN
	EXISTING SANITARY MANHOLE
	EXISTING GATE VALVE
	EXISTING WATER METER

GENERAL NOTES

1. CONFIRM EXISTING CONDITIONS IN THE FIELD PRIOR TO PERFORMING ANY WORK.
2. EXISTING BUILDINGS ARE TO REMAIN OPERATIONAL THROUGHOUT CONSTRUCTION. COORDINATE ANY UNFORESEEN OUTAGES WITH THE JPS I.T. MANAGER PRIOR TO PERFORMING THE WORK.
3. COORDINATE COMMUNICATION PATHWAY SYSTEMS WITH OTHER UTILITIES PRIOR TO INSTALLATION.
4. COORDINATE ENTRY INTO THE BUILDING WITH JPS PDC AND STRUCTURAL ENGINEERS PRIOR TO INSTALLATION.
5. REFER TO TECHNOLOGY PLANS FOR HAND HOLE / VAULT DETAILS FOR SPECIFICATIONS ON CONDUIT PENETRATIONS, INCLUDING REQUIRED QUANTITIES AND ADDITIONAL INSTALLATION REQUIREMENTS.
6. CONDUIT FROM HAND HOLES/VAULTS TO BUILDINGS TO BE INSTALLED BY OTHERS AND SHOWN FOR REFERENCE ONLY.
7. CONDUITS CROSSING PUBLIC RIGHT-OF-WAY TO BE PLACED IN SINGLE BORE PIPES UNLESS NOTED OTHERWISE. REFER TO CIVIL ENCROACHMENT AGREEMENT EXHIBITS FOR CROSSINGS AND DEPTH.

The image shows the official seal of the State of Texas, which is circular with a five-pointed star in the center. The words "STATE OF TEXAS" are written in a semi-circle at the top, and "PROFESSIONAL ENGINEER" are at the bottom. The number "138744" is in the center of the star. Overlaid on the bottom left of the seal is a blue, handwritten signature that reads "Hunter M. Brauer".

JOB NO.	12229.001
DESIGNED BY:	HB
DRAWN BY:	AC/EG
CHECKED BY:	HB
DATE:	DEC 2025
SHEET:	C2.3

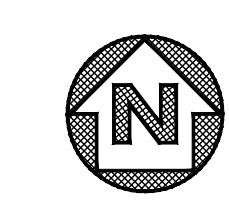

A graphic scale in feet, marked at 0, 40, and 80. The scale is represented by a horizontal line with black and white segments. The text "GRAPHIC SCALE IN FEET" is centered below the scale.

C2.3



KEY MAP

UTILITY LEGEND	
	PROPERTY BOUNDARY
	ADJOINERS
	FIBER OPTIC LINE
	FIBER OPTIC LINE (BY OTHERS)
	STORM DRAIN (BY OTHERS)
	WATER LINE (BY OTHERS)
	SANITARY SEWER LINE (BY OTHERS)
	GAS LINE (BY OTHERS)
	OVERHEAD ELECTRIC (BY OTHERS)
	UNDERGROUND ELECTRIC (BY OTHERS)
	SANITARY SEWER MANHOLE (BY OTHERS)
	SANITARY SEWER CLEANOUT (BY OTHERS)
	WATER METER (BY OTHERS)
	FIRE HYDRANT (BY OTHERS)
	GATE VALVE (BY OTHERS)
	EXISTING SANITARY SEWER LINE
	EXISTING WATER LINE
	EXISTING GAS LINE
	EXISTING UNDERGROUND ELECTRIC
	EXISTING FIBER OPTIC
	EXISTING OVERHEAD ELECTRIC
	EXISTING TELEPHONE
	EXISTING STORM DRAIN
	EXISTING SANITARY MANHOLE
	EXISTING GATE VALVE
	EXISTING WATER METER

GENERAL NOTES

1. CONFIRM EXISTING CONDITIONS IN THE FIELD PRIOR TO PERFORMING ANY WORK.
2. EXISTING BUILDINGS ARE TO REMAIN OPERATIONAL THROUGHOUT CONSTRUCTION. COORDINATE ANY UNFORESEEN OUTAGES WITH THE JPS I.T. MANAGER PRIOR TO PERFORMING THE WORK.
3. COORDINATE COMMUNICATION PATHWAY SYSTEMS WITH OTHER UTILITIES PRIOR TO INSTALLATION.
4. COORDINATE ENTRY INTO THE BUILDING WITH JPS PDC AND STRUCTURAL ENGINEERS PRIOR TO INSTALLATION.
5. REFER TO TECHNOLOGY PLANS FOR HAND HOLE / VAULT DETAILS FOR SPECIFICATIONS ON CONDUIT PENETRATIONS, INCLUDING REQUIRED QUANTITIES AND ADDITIONAL INSTALLATION REQUIREMENTS.
6. CONDUIT FROM HAND HOLES/VAULTS TO BUILDINGS TO BE INSTALLED BY OTHERS AND SHOWN FOR REFERENCE ONLY.
7. CONDUITS CROSSING PUBLIC RIGHT-OF-WAY TO BE PLACED IN SINGLE BORE PIPES UNLESS NOTED OTHERWISE. REFER TO CIVIL ENCROACHMENT AGREEMENT EXHIBITS FOR CROSSINGS AND DEPTH.

MATCH LINE SHEET C2.5

WARNING TO CONTRACTOR:	
CALL TEXAS 811 (LOCATING SERVICE) OR OTHER UTILITY LOCATING SERVICES 48 HOURS PRIOR TO CONSTRUCTION ACTIVITY. EXISTING UTILITY DATA IS PROVIDED FOR INFORMATION ONLY. ALTHOUGH THIS DATA IS SHOWN AS ACCURATELY AS POSSIBLE, THE CONTRACTOR IS CAUTIONED THAT DUNAWAY ASSOCIATES L.P. DOES NOT ASSUME OR IMPLY ANY RESPONSIBILITY FOR THE ACCURACY OF THIS DATA.	
UTILITY NOTE:	
THE UTILITIES SHOWN ON THE PLANS WERE COMPILED FROM VARIOUS SOURCES AND ARE INTENDED TO SHOW THE GENERAL EXISTENCE AND LOCATION OF UTILITIES IN THE AREA OF CONSTRUCTION. THE ENGINEER ASSUMES NO RESPONSIBILITY FOR THE ACCURACY OF THE UTILITY INFORMATION SHOWN ON THE PLANS. THE CONTRACTOR SHALL VERIFY THE EXACT LOCATION OF ALL UTILITIES PRIOR TO CONSTRUCTION. THE CONTRACTOR SHALL CONTACT UTILITY COMPANIES 48 HOURS IN ADVANCE OF ANY CONSTRUCTION ACTIVITIES TO DETERMINE IF THERE ARE ANY CONFLICTS WITH THE PROPOSED FACILITY. THE CONTRACTOR SHALL NOTIFY THE ENGINEER IMMEDIATELY WHEN CONFLICTS WITH EXISTING UTILITIES ARE DISCOVERED. THE FOLLOWING PHONE NUMBERS ARE PROVIDED FOR CONVENIENCE. CONSIDERATION OF OTHER UTILITIES MAY BE REQUIRED.	
FORT WORTH WATER DEPT FORT WORTH (PWA) TEXAS 811 (LOCATING SERVICE) CHARTER COMMUNICATIONS (TV CABLE) MCI (OWNER OF WESTERN UNION LINES) AT&T VERIZON ATMOS ENERGY ONCOR ELECTRIC DELIVERY SPRINT ZAYO	(817) 392-8296 (817) 392-8100 (888) 438-2427 (800) 624-9675 (817) 338-6202 (800) 483-1000 (800) 817-8090 (888) 215-6688 (800) 521-0579


NO.	DATE	REVISIONS	DESCRIPTION
1	11/07/2025	ADDENDUM #1	

DUNAWAY
550 Bailey Avenue • Suite 400 • Fort Worth, Texas 76107
(TX) REG. F-1114

JPS CAMPUS
FIBER LOOP PROJECT
FORT WORTH, TX

MATCH LINE SHEET C2.3

12/23/2025	
STATE OF TEXAS	
HUNTER M. BRAUER 138744 LICENSED	
12229.001	
JOB NO.	12229.001
DESIGNED BY:	HB
DRAWN BY:	AC/EG
CHECKED BY:	HB
DATE:	DEC 2025
SHEET:	C2.4

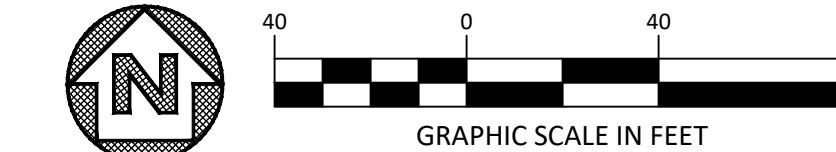


GRAPHIC SCALE IN FEET

C2.4

GENERAL NOTES

1. CONFIRM EXISTING CONDITIONS IN THE FIELD PRIOR TO PERFORMING ANY WORK.
2. EXISTING BUILDINGS ARE TO REMAIN OPERATIONAL THROUGHOUT CONSTRUCTION. COORDINATE ANY UNFORESEEN OUTAGES WITH THE JPS I.T. MANAGER PRIOR TO PERFORMING THE WORK.
3. COORDINATE COMMUNICATION PATHWAY SYSTEMS WITH OTHER UTILITIES PRIOR TO INSTALLATION.
4. COORDINATE ENTRY INTO THE BUILDING WITH JPS PDC AND STRUCTURAL ENGINEERS PRIOR TO INSTALLATION.
5. REFER TO TECHNOLOGY PLANS FOR HAND HOLE / VAULT DETAILS FOR SPECIFICATIONS ON CONDUIT PENETRATIONS, INCLUDING REQUIRED QUANTITIES AND ADDITIONAL INSTALLATION REQUIREMENTS.
6. CONDUIT FROM HAND HOLES/VAULTS TO BUILDINGS TO BE INSTALLED BY OTHERS AND SHOWN FOR REFERENCE ONLY.
7. CONDUITS CROSSING PUBLIC RIGHT-OF-WAY TO BE PLACED IN SINGLE BORE PIPES UNLESS NOTED OTHERWISE. REFER TO CIVIL ENROACHMENT AGREEMENT EXHIBITS FOR CROSSINGS AND DEPTH.

UTILITY LEGEND	
—	PROPERTY BOUNDARY
- - -	ADJOINERS
— FO —	FIBER OPTIC LINE
— FO — (BY OTHERS)	FIBER OPTIC LINE (BY OTHERS)
— SS —	STORM DRAIN (BY OTHERS)
— W —	WATER LINE (BY OTHERS)
— SS —	SANITARY SEWER LINE (BY OTHERS)
— GAS —	GAS LINE (BY OTHERS)
— OHE —	OVERHEAD ELECTRIC (BY OTHERS)
— UE —	UNDERGROUND ELECTRIC (BY OTHERS)
● —	SANITARY SEWER MANHOLE (BY OTHERS)
● ● —	SANITARY SEWER CLEANOUT (BY OTHERS)
— W —	WATER METER (BY OTHERS)
— FH —	FIRE HYDRANT (BY OTHERS)
— GV —	GATE VALVE (BY OTHERS)
— EX-6 SS —	EXISTING SANITARY SEWER LINE
— EX-12' W —	EXISTING WATER LINE
— EX-GAS —	EXISTING GAS LINE
— EX-UE —	EXISTING UNDERGROUND ELECTRIC
— EX-FO —	EXISTING FIBER OPTIC
— EX-OHE —	EXISTING OVERHEAD ELECTRIC
— EX-T —	EXISTING TELEPHONE
— EX-SD —	EXISTING STORM DRAIN
— SS —	EXISTING SANITARY MANHOLE
— GV —	EXISTING GATE VALVE
— W —	EXISTING WATER METER

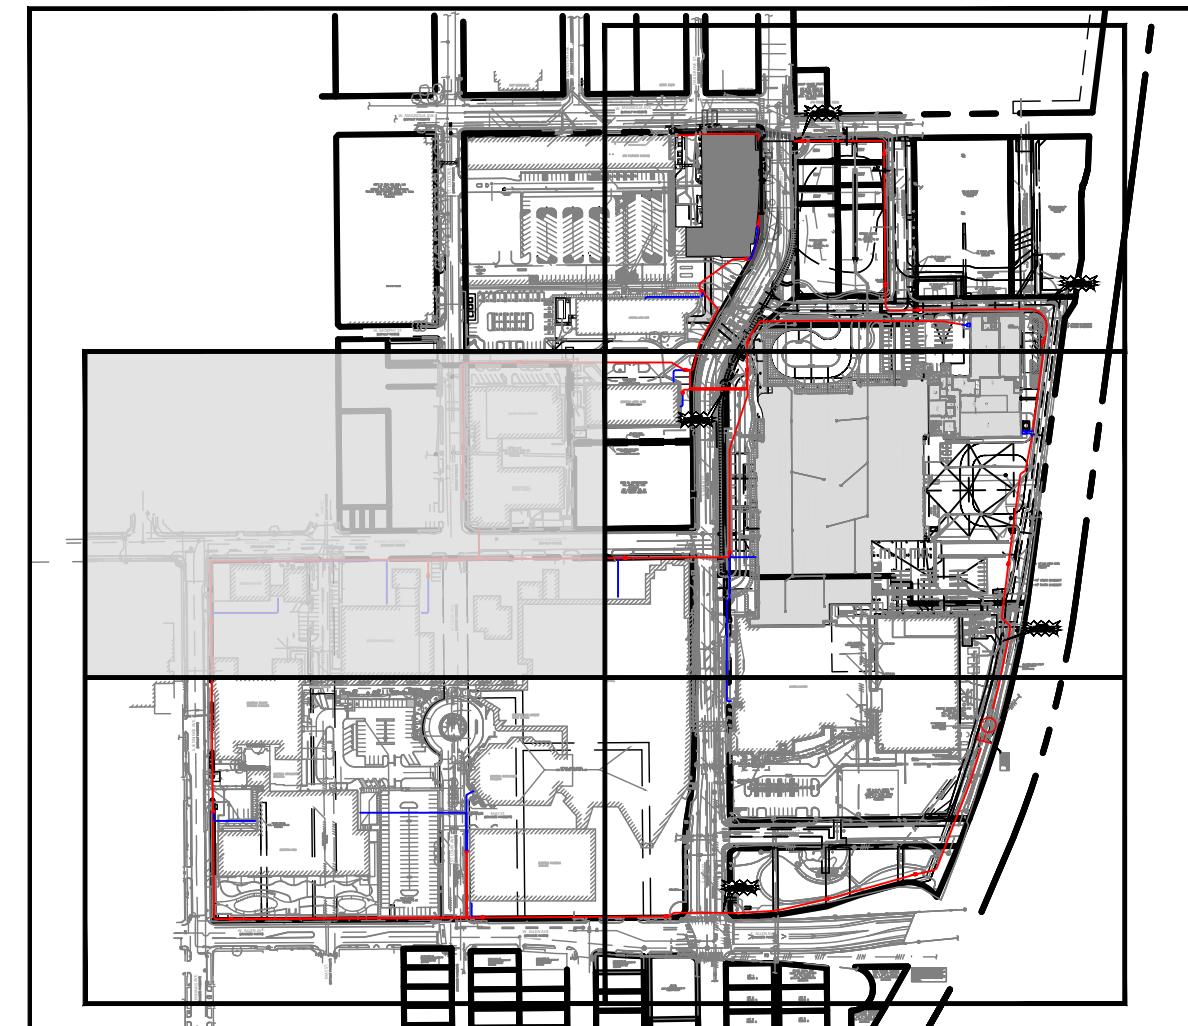


KEY MAP

WARNING TO CONTRACTOR:
CALL TEXAS 811 (LOCATING SERVICE) OR OTHER UTILITY LOCATING SERVICES 48 HOURS PRIOR TO CONSTRUCTION ACTIVITY. EXISTING UTILITY DATA IS PROVIDED FOR INFORMATION ONLY. ALTHOUGH THIS DATA IS SHOWN AS ACCURATELY AS POSSIBLE, THE CONTRACTOR IS CAUTIONED THAT DUNAWAY ASSOCIATES L.P. DOES NOT ASSUME OR IMPLY ANY RESPONSIBILITY FOR THE ACCURACY OF THIS DATA.

UTILITY NOTE:
THE UTILITIES SHOWN ON THE PLANS WERE COMPILED FROM VARIOUS SOURCES AND ARE INTENDED TO SHOW THE GENERAL EXISTENCE AND LOCATION OF UTILITIES IN THE AREA OF CONSTRUCTION. THE ENGINEER IS NOT RESPONSIBLE FOR THE ACCURACY OF THE INFORMATION SHOWN ON THE PLANS. THE CONTRACTOR SHALL VERIFY THE EXACT LOCATION OF ALL UTILITIES PRIOR TO CONSTRUCTION. THE CONTRACTOR SHALL CONTACT UTILITY COMPANIES 48 HOURS IN ADVANCE OF ANY CONSTRUCTION ACTIVITIES IN ORDER TO DETERMINE IF THERE IS ANY CONFLICT WITH THE PROPOSED FACILITIES. THE CONTRACTOR SHALL NOTIFY THE ENGINEER IMMEDIATELY WHEN CONFLICTS WITH EXISTING UTILITIES ARE DISCOVERED. THE FOLLOWING PHONE NUMBERS ARE PROVIDED FOR CONVENIENCE. CONSIDERATION OF OTHER UTILITIES MAY BE REQUIRED.

FORT WORTH WATER DEPT (817) 392-8296
FORT WORTH TPW (817) 392-8100
TEXAS 811 (LOCATING SERVICE) 811
CHARTER COMMUNICATIONS (TV CABLE) (888) 438-2427
MCI (OWNER OF WESTERN UNION LINES) (800) 624-9125
MCI (800) 222-2020
VERIZON (800) 483-1000
ATMOS ENERGY (800) 817-8090
ONCOR ELECTRIC DELIVERY (888) 215-6688
SPRINT (800) 521-0579
ZAYO

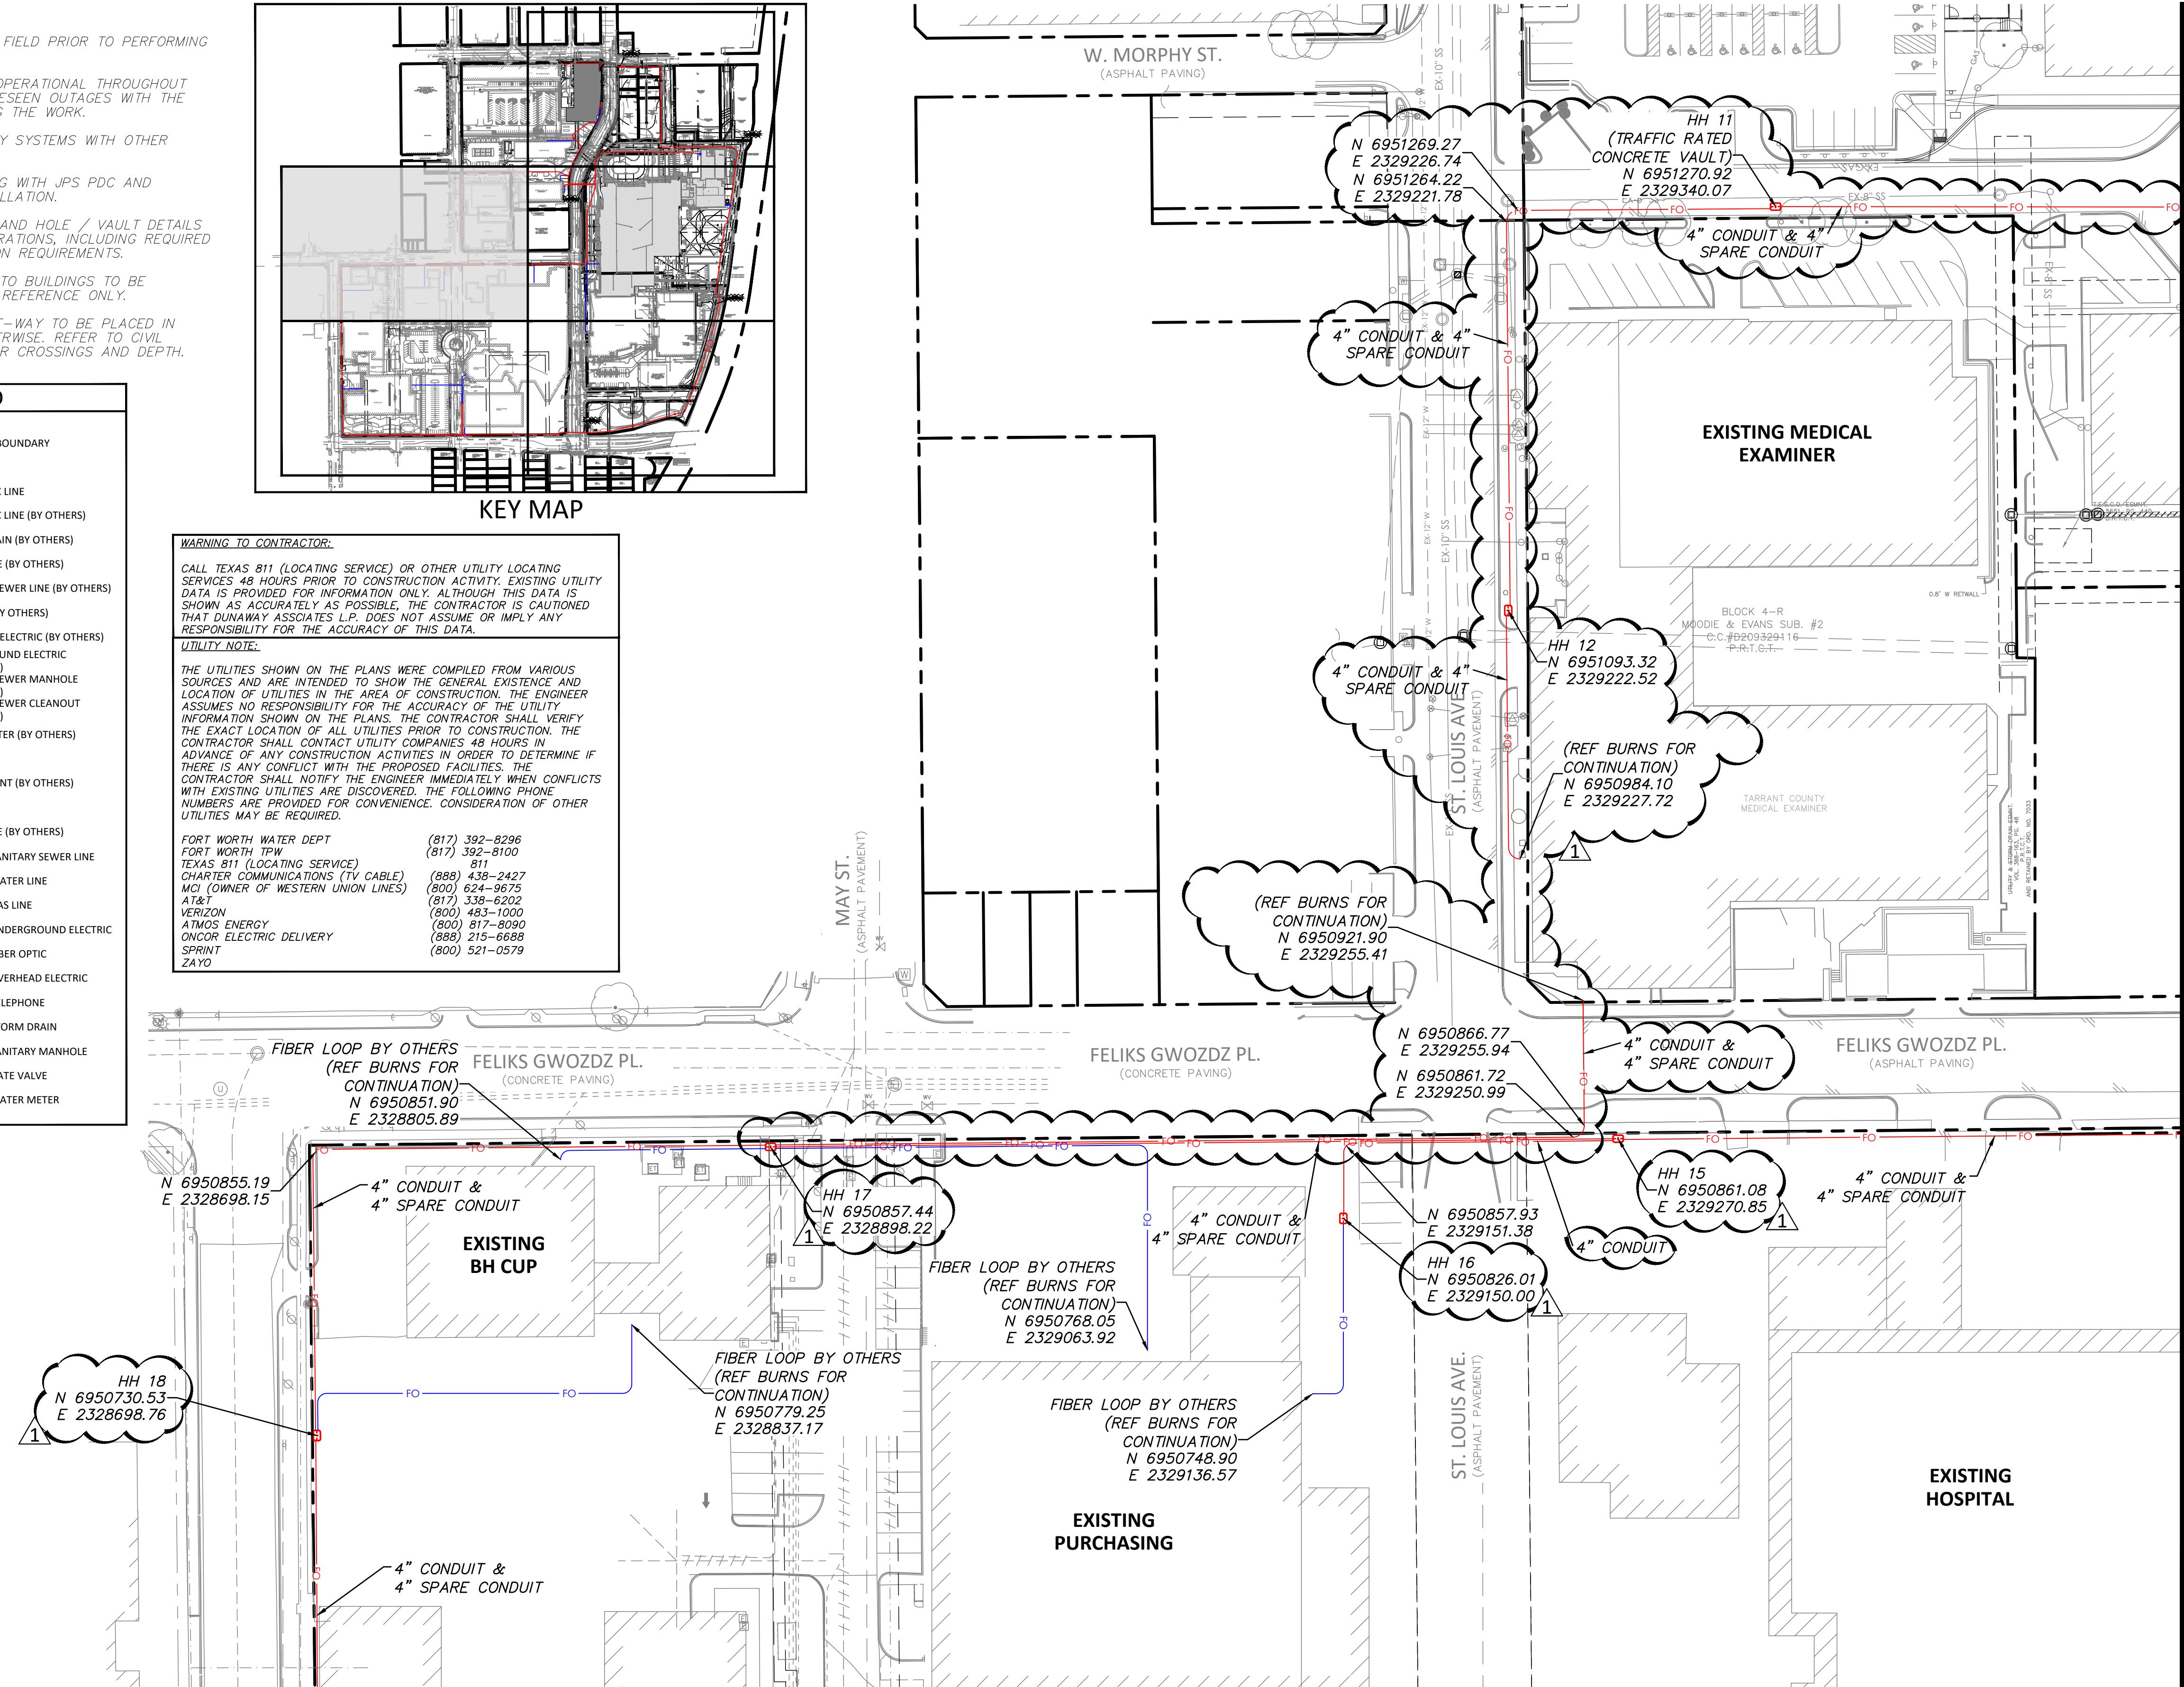

MATCH LINE SHEET C2.4


MATCH LINE SHEET C2.2

DIMENSIONAL CONTROL PLAN


JPS CAMPUS
FIBER LOOP PROJECT
FORT WORTH, TX

NO.	DATE	REVISIONS	DESCRIPTION
1	12/22/25	ADDENDUM #1	

DUNAWAY
550 Bailey Avenue • Suite 400 • Fort Worth, Texas 76107
Tel: 817.235.1121
(TX Reg. F-1114)

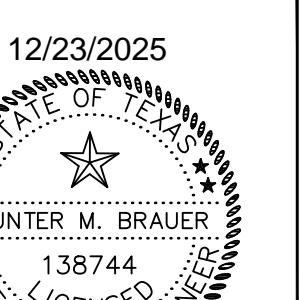

JOB NO. 12229.001
DESIGNED BY: HB
DRAWN BY: AC/EG
CHECKED BY: HB
DATE: DEC 2025
SHEET: C2.5

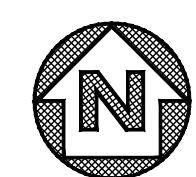

40 0 40 80
GRAPHIC SCALE IN FEET

